


Contract Drawings For

CORDOVA FISH PASSAGE IMPROVEMENT PROJECTS COPPER RIVER HIGHWAY - MP 18.7 18 MILE CREEK CROSSING - COP 25 U.S. FISH AND WILDLIFE SERVICE

SECTION 30, TOWNSHIP 16 SOUTH, RANGE 1 EAST, COPPER RIVER MERIDIAN, ALASKA
DECEMBER 2020

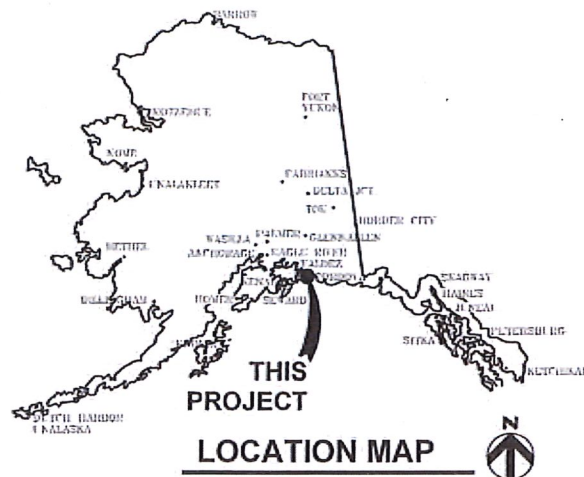

PROJECT LOCATION		
ADF&G SITE NO.	CRWP ID	COPPER RIVER HWY MP
20100491	COP 25	18.7

DESIGN DESIGNATIONS	
AADT 2015	244

AS-BUILT PLANS


Project Engineer: Forrester Cook; DOWL

CONTRACTOR: WILSON CONSTRUCTION, INC.

SUPERINTENDENT: JOHN BAENEN

BEGIN DATE OF WORK: MAY 20, 2021

END DAY OF WORK: AUGUST 7, 2021

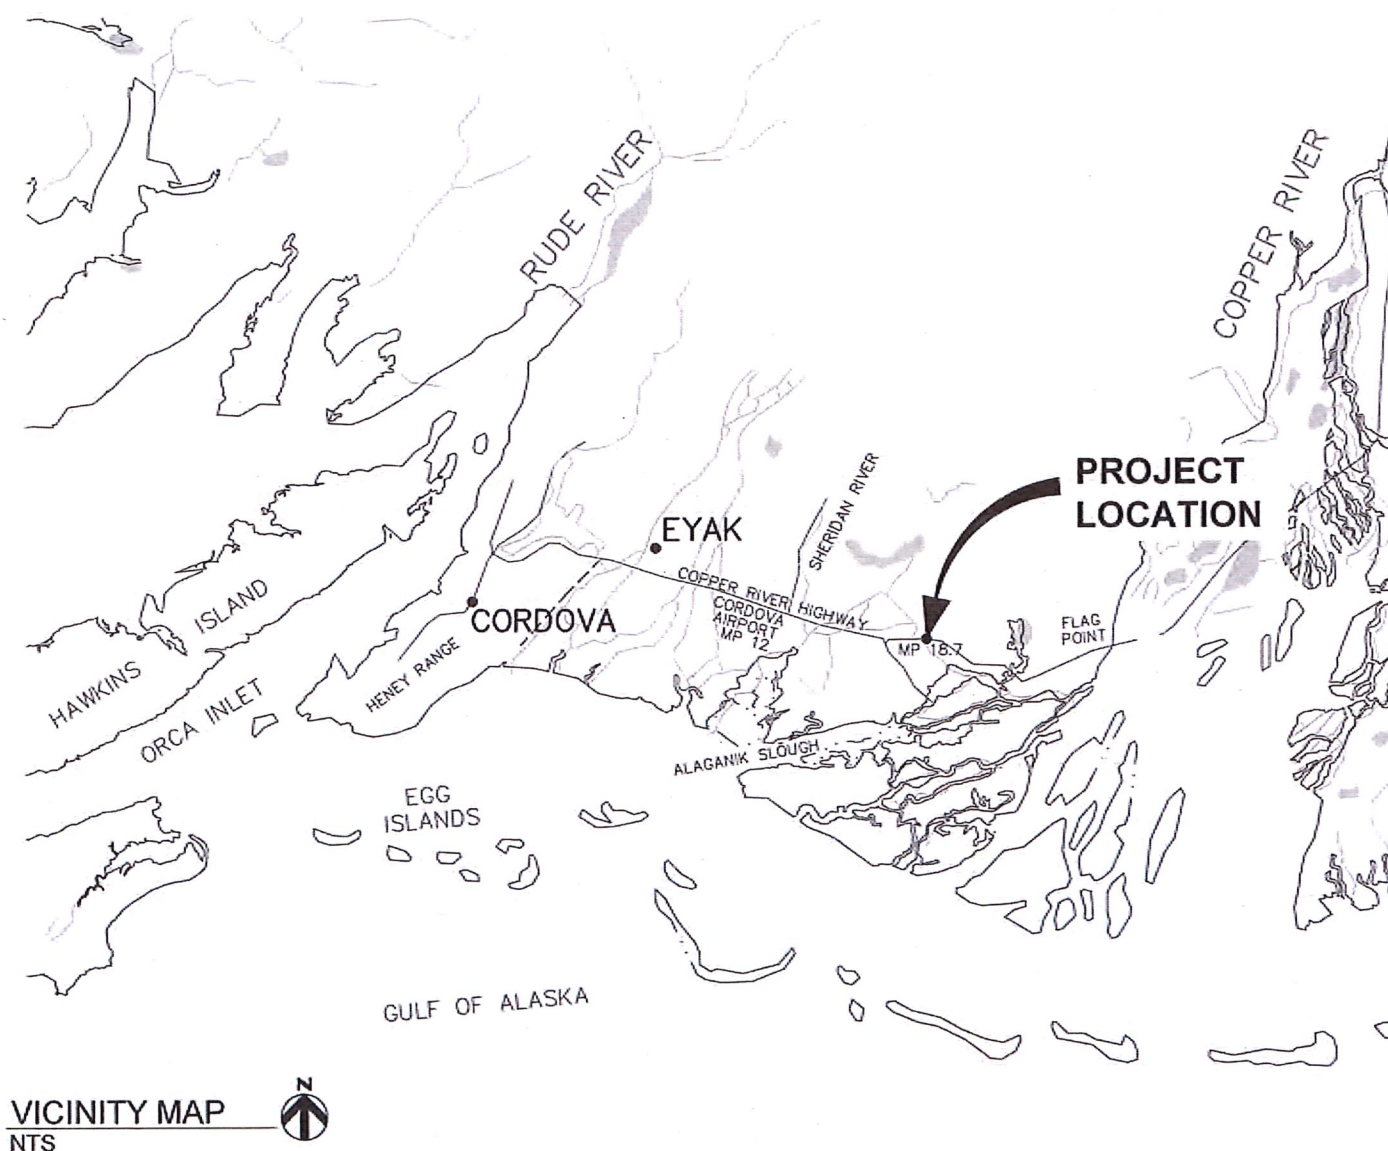

DRAWING INDEX

- C1 COVER SHEET
- C2 GENERAL NOTES AND QUANTITIES
- C3-C4 SURVEY CONTROL
- C5 EXISTING STREAM PLAN AND PROFILE
- C6 STREAM PLAN AND PROFILE
- C7 ROADWAY PLAN AND PROFILE
- C8 STREAM DESIGN DETAILS
- C9 STREAM SECTIONS AND DETAILS
- C10 ESCP, STREAM DIVERSION & ROADWAY DIVERSION PLAN
- C11 REVEGETATION PLAN

PREPARED BY:



ESTIMATE OF QUANTITIES			
ITEM NO.	ITEM DESCRIPTION	PAY UNIT	QUANTITY
201(9)	CLEARING AND GRUBBING	LUMP SUM	ALL REQUIRED
202(4)	REMOVAL OF CULVERT PIPE	LINEAR FOOT	121
203(3)	UNCLASSIFIED EXCAVATION	CUBIC YARD	1254
203(5A)	BORROW, SELECTED MATERIAL, TYPE A	CUBIC YARD	1331
203(5B)	SUBBASE, GRADING F	CUBIC YARD	583
301(4)	AGGREGATE SURFACE COURSE, GRADING E-1	CUBIC YARD	55
603(10)	CORRUGATED ALUMINUM PIPE ARCH, 71" SPAN, 47" RISE	LINEAR FOOT	70
602(4)	STRUCTURAL PLATE ALUMINUM BOX CULVERT, 29'-0" SPAN, 8'-3" RISE	LINEAR FOOT	76
611(1A)	RIPRAP, CLASS I	CUBIC YARD	143
611(1B)	RIPRAP, CLASS II	CUBIC YARD	154
613(2)	CULVERT MARKER POST	EACH	4
618(2)	SEEDING	POUND	2
620(1)	TOPSOIL (4")	SQUARE YARD	220
630(3B)	GEOTEXTILE, REINFORCEMENT, TYPE 2	SQUARE YARD	1080
631(2)	GEOTEXTILE, EROSION CONTROL, CLASS 1	SQUARE YARD	117
640(1)	MOBILIZATION AND DEMOBILIZATION	LUMP SUM	ALL REQUIRED
641(3)	TEMPORARY EROSION, SEDIMENT AND POLLUTION CONTROL	LUMP SUM	ALL REQUIRED
642(1)	CONSTRUCTION SURVEYING	LUMP SUM	ALL REQUIRED
642(14)	AS-BUILT PLANS	LUMP SUM	ALL REQUIRED
643(2)	TRAFFIC MAINTENANCE	LUMP SUM	ALL REQUIRED
644(15)	NUCLEAR TESTING EQUIPMENT STORAGE SHED	LUMP SUM	ALL REQUIRED
672(1)	STREAM DIVERSION & DEWATERING	LUMP SUM	ALL REQUIRED
690(10)	WATERWAY BED FILL	LINEAR FOOT	125
690(12)	WATERWAY BANK REVEGETATION AND PROTECTION	LUMP SUM	ALL REQUIRED
690(13)	ROUNDED RIVER ROCK	CUBIC YARD	99

2

1

1

LEGEND

	DESCRIPTION
---	APPROXIMATE RIGHT-OF-WAY
⊙	CONTROL POINT
----	ORDINARY HIGH WATER
- - - - -	EXISTING CULVERT
=====	EDGE OF PAVEMENT
=====	EDGE OF GRAVEL/SHOULDER
~~~~~	EDGE OF VEGETATION
→	EXISTING THALWEG
=====	TOP OF BANK
=====	TOE OF SLOPE
=====	PROPOSED CULVERT
=====	WATERWAY BED FILL
=====	WATERWAY BANK REVEGETATION AND PROTECTION
=====	RIPRAP
=====	ROUNDED RIVER ROCK
=====	AGGREGATE SURFACE COURSE, E-1
=====	SELECTED MATERIAL, TYPE A
=====	SUBBASE, GRADING F
=====	SEED
=====	BULK BAG COFFERDAM

ABBREVIATIONS

ALCAP	ALUMINUM CAP
AVASP	AS VERTICAL AS SAFELY POSSIBLE
BFW	BANKFULL WIDTH
BOF	BOTTOM OF FOOTING
CFS	CUBIC FEET PER SECOND
CL	CENTERLINE
CMP	CORRUGATED METAL PIPE
CRH	COPPER RIVER HIGHWAY
ELEV	ELEVATION
ESCP	EROSION AND SEDIMENT CONTROL PLAN
HW/D	HEADWATER TO DEPTH RATIO
INV	INVERT ELEVATION
MIN	MINIMUM
MP	MILEPOST
NTS	NOT TO SCALE
OHW	ORDINARY HIGH WATER
OSHA	OCCUPATIONAL SAFETY AND HEALTH ADMINISTRATION
Q	FLOW
ROW	RIGHT-OF-WAY
STA	STATION
TYP	TYPICAL
VAP	VERTICAL ADJUSTMENT POTENTIAL

TABLE 1

COARSE MATERIAL: RIPRAP, CLASS I

APPROX. SIZE	MASS (LBS)	% PASSING
10"	50	100
8"	25	50

TABLE 2

FINE MATERIAL: POROUS BACKFILL

SIZE/SIEVE	% PASSING
3"	100
1"	65
0.75"	50
#4	25
#10	15

GENERAL NOTES

- THE CONTRACTOR IS RESPONSIBLE FOR DETERMINING THE EXACT LOCATION OF ALL SITE FEATURES. IF THE CONTRACTOR DISCOVERS CONDITIONS OTHER THAN THOSE SHOWN ON THE PLANS, CONTRACTOR SHALL IMMEDIATELY NOTIFY THE OWNER'S REPRESENTATIVE.
- COORDINATE CONSTRUCTION STAGING AND MOBILIZATION AREAS AND ACTIVITIES WITH OWNER'S REPRESENTATIVE.
- COORDINATE WITH OTHER CONTRACTORS WHO MAY BE PRESENT.
- EXERCISE CAUTION AND COMPLY WITH ALL APPLICABLE OSHA REQUIREMENTS FOR WORKING IN CONFINED AREAS.
- STATIONING IS ALONG CENTERLINE OF STREAM OR ROADWAY.
- VERIFY ELEVATIONS OF ALL PROPOSED STRUCTURES PRIOR TO CONSTRUCTION. REPORT ANY DISCREPANCIES FROM PLANS IMMEDIATELY TO OWNER'S REPRESENTATIVE.
- CULVERT DESIGN LOAD: AASHTO LOADING HL-93, MINIMUM SOIL BEARING CAPACITY: 3,900 PSF.
- EXCAVATION AND COMPACTION:
  - REMOVE AND DISPOSE OF ALL ORGANIC OR OVER SATURATED SOFT MATERIAL, WHICH CANNOT BE COMPACTED.
  - BACKFILL SHALL BE PLACED AND COMPACTED WITH CARE AND SHALL BE BROUGHT UP EVENLY AND SIMULTANEOUSLY ON BOTH SIDES OF PIPE. MATERIAL TO BE COMPACTED TO 95% MAXIMUM DENSITY.
- CULVERT INSTALLATION:
  - CULVERT JOINTS SHALL NOT LEAK.
  - CULVERT INFILL MATERIAL SHALL BE INSTALLED IN PIPE ACCORDING TO PLANS. MANUAL INSTALLATION IS REQUIRED.
- ALL VEGETATION IN THE AREAS NOT AFFECTED BY WORK SHALL BE PRESERVED AND PROTECTED BY THE CONTRACTOR. RESEED ALL DISTURBED AREAS.
- TWO CULVERT MARKERS WILL BE INSTALLED AT EACH CULVERT PER STD D-09.00.

TABLE 3

WATERWAY BED FILL

SIZE/SIEVE	% PASSING
12"	100
10"	95
8"	73
5"	56
3"	51
1"	29
0.75"	23
#4	11
#10	7


TABLE 4

ROUNDED RIVER ROCK

SIZE/SIEVE	% PASSING
12"	100
9"	75
6"	30
3"	15
1"	10
0.75"	5
#4	0
#10	0

THE FOLLOWING DOT&PF STANDARD DRAWING APPLIES TO THIS PROJECT:  
D-09.00 CULVERT MARKER POST

REV	DATE	DESCRIPTION	BY
1	1/21/21	ADDENDUM #1	
2	1/22/21	ADDENDUM #2	

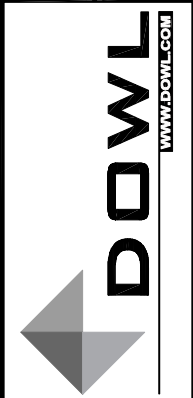


CORDOVA FISH PASSAGE IMPROVEMENTS  
EAST FORK 18 MILE CREEK - COP 25  
GENERAL NOTES AND QUANTITIES  
CORDOVA, ALASKA

PROJECT 1136.63087.01  
DATE DECEMBER 2020

© DOWL 2020  
SHEET




C:\Civil 3D Projects 2018\2018\36\63087-01\Survey\MC-VB-BA-63087-COP25.dwg PLOT DATE 2020-12-4 09:31 SAVED DATE 2020-12-03 16:06 USER: hrbuck

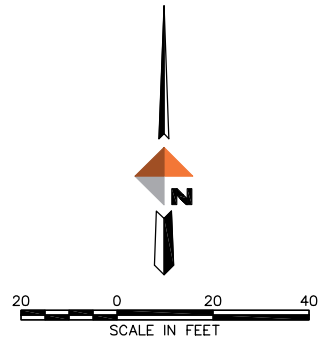

LEGEND	
	SURVEY MONUMENT
	CULVERT
	EDGE OF GRAVEL
	EDGE OF WATER
	RIFFLE AREA OUTLINE
	CENTERLINE CHANNEL
	MAJOR CONTOUR (5 FEET)
	MINOR CONTOUR (1 FOOT)
	RIGHT-OF-WAY LINE

COPPER RIVER HIGHWAY RIGHT-OF-WAY IS 100 FEET EACH SIDE OF CENTERLINE PER OMNIBUS BILL 1959. LOCATION SHOWN IS BASED ON FIELD SURVEYED CENTER OF ROADWAY, AND IS FOR VISUAL REFERENCE ONLY.

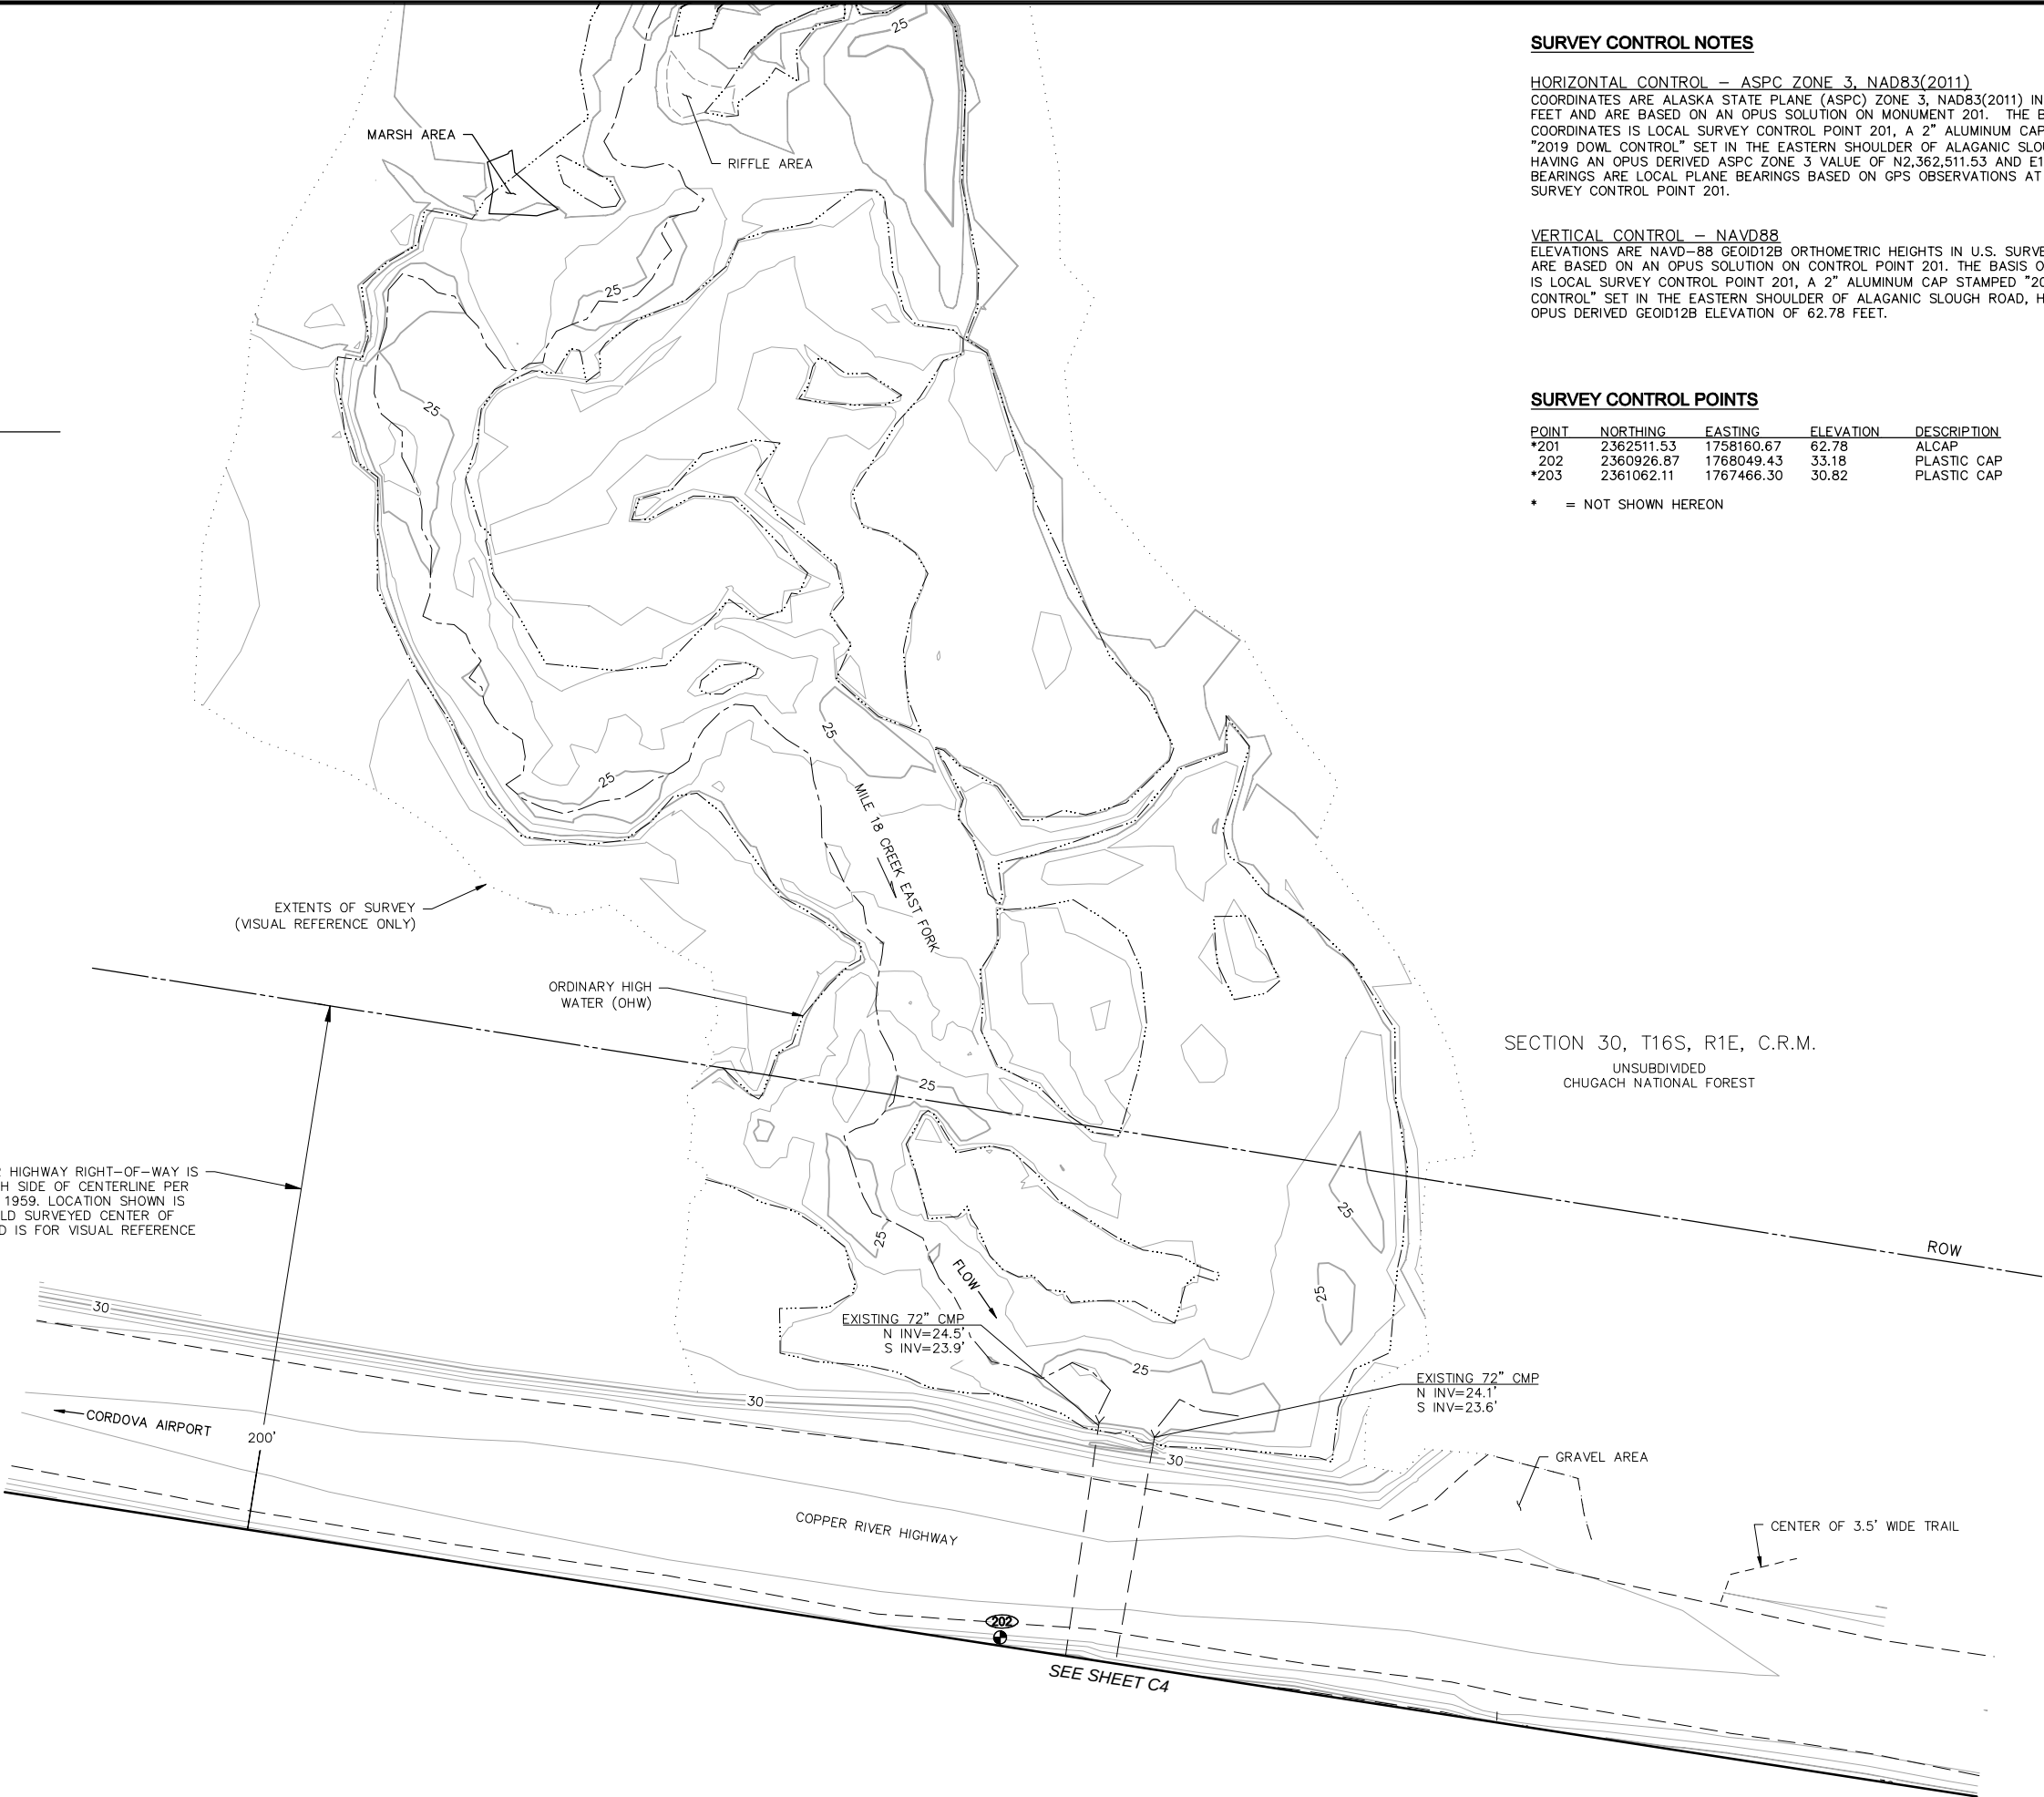

SURVEY CONTROL NOTES

HORIZONTAL CONTROL – ASPC ZONE 3, NAD83(2011)  
COORDINATES ARE ALASKA STATE PLANE (ASPC) ZONE 3, NAD83(2011) IN U.S. SURVEY FEET AND ARE BASED ON AN OPUS SOLUTION ON MONUMENT 201. THE BASIS OF COORDINATES IS LOCAL SURVEY CONTROL POINT 201, A 2" ALUMINUM CAP STAMPED "2019 DOWL CONTROL" SET IN THE EASTERN SHOULDER OF ALAGANIC SLOUGH ROAD, HAVING AN OPUS DERIVED ASPC ZONE 3 VALUE OF N2,362,511.53 AND E1,758,160.67. BEARINGS ARE LOCAL PLANE BEARINGS BASED ON GPS OBSERVATIONS AT LOCAL SURVEY CONTROL POINT 201.


VERTICAL CONTROL – NAVD88  
ELEVATIONS ARE NAVD-88 GEOID12B ORTHOMETRIC HEIGHTS IN U.S. SURVEY FEET AND ARE BASED ON AN OPUS SOLUTION ON CONTROL POINT 201. THE BASIS OF ELEVATIONS IS LOCAL SURVEY CONTROL POINT 201, A 2" ALUMINUM CAP STAMPED "2019 DOWL CONTROL" SET IN THE EASTERN SHOULDER OF ALAGANIC SLOUGH ROAD, HAVING AN OPUS DERIVED GEOID12B ELEVATION OF 62.78 FEET.

SURVEY CONTROL POINTS

POINT	NORTHING	EASTING	ELEVATION	DESCRIPTION
*201	2362511.53	1758160.67	62.78	ALCAP
202	2360926.87	1768049.43	33.18	PLASTIC CAP
*203	2361062.11	1767466.30	30.82	PLASTIC CAP

* = NOT SHOWN HEREON

REVISIONS		DESCRIPTION	BY
REV	DATE		

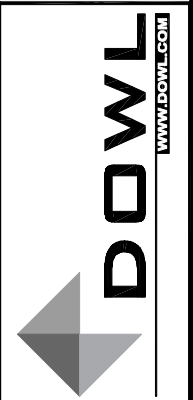


CORDOVA FISH PASSAGE IMPROVEMENTS  
EAST FORK 18 MILE CREEK – COP 25  
SURVEY CONTROL  
SECTION 30, T16S, R1E, C.R.M. ALASKA  
CORDOVA RECORDING DISTRICT, ALASKA

PROJECT 1136.63087.01  
DATE DECEMBER 2020

© DOWL 2020  
SHEET

C3 OF C11

C:\Civil 3D Projects 2018\2018\36\63087-01\Survey MC-VB-BA-63087-COP25.dwg PLOT DATE 2020-12-4 09:32 SAVED DATE 2020-12-03 16:06 USER: hrbuck

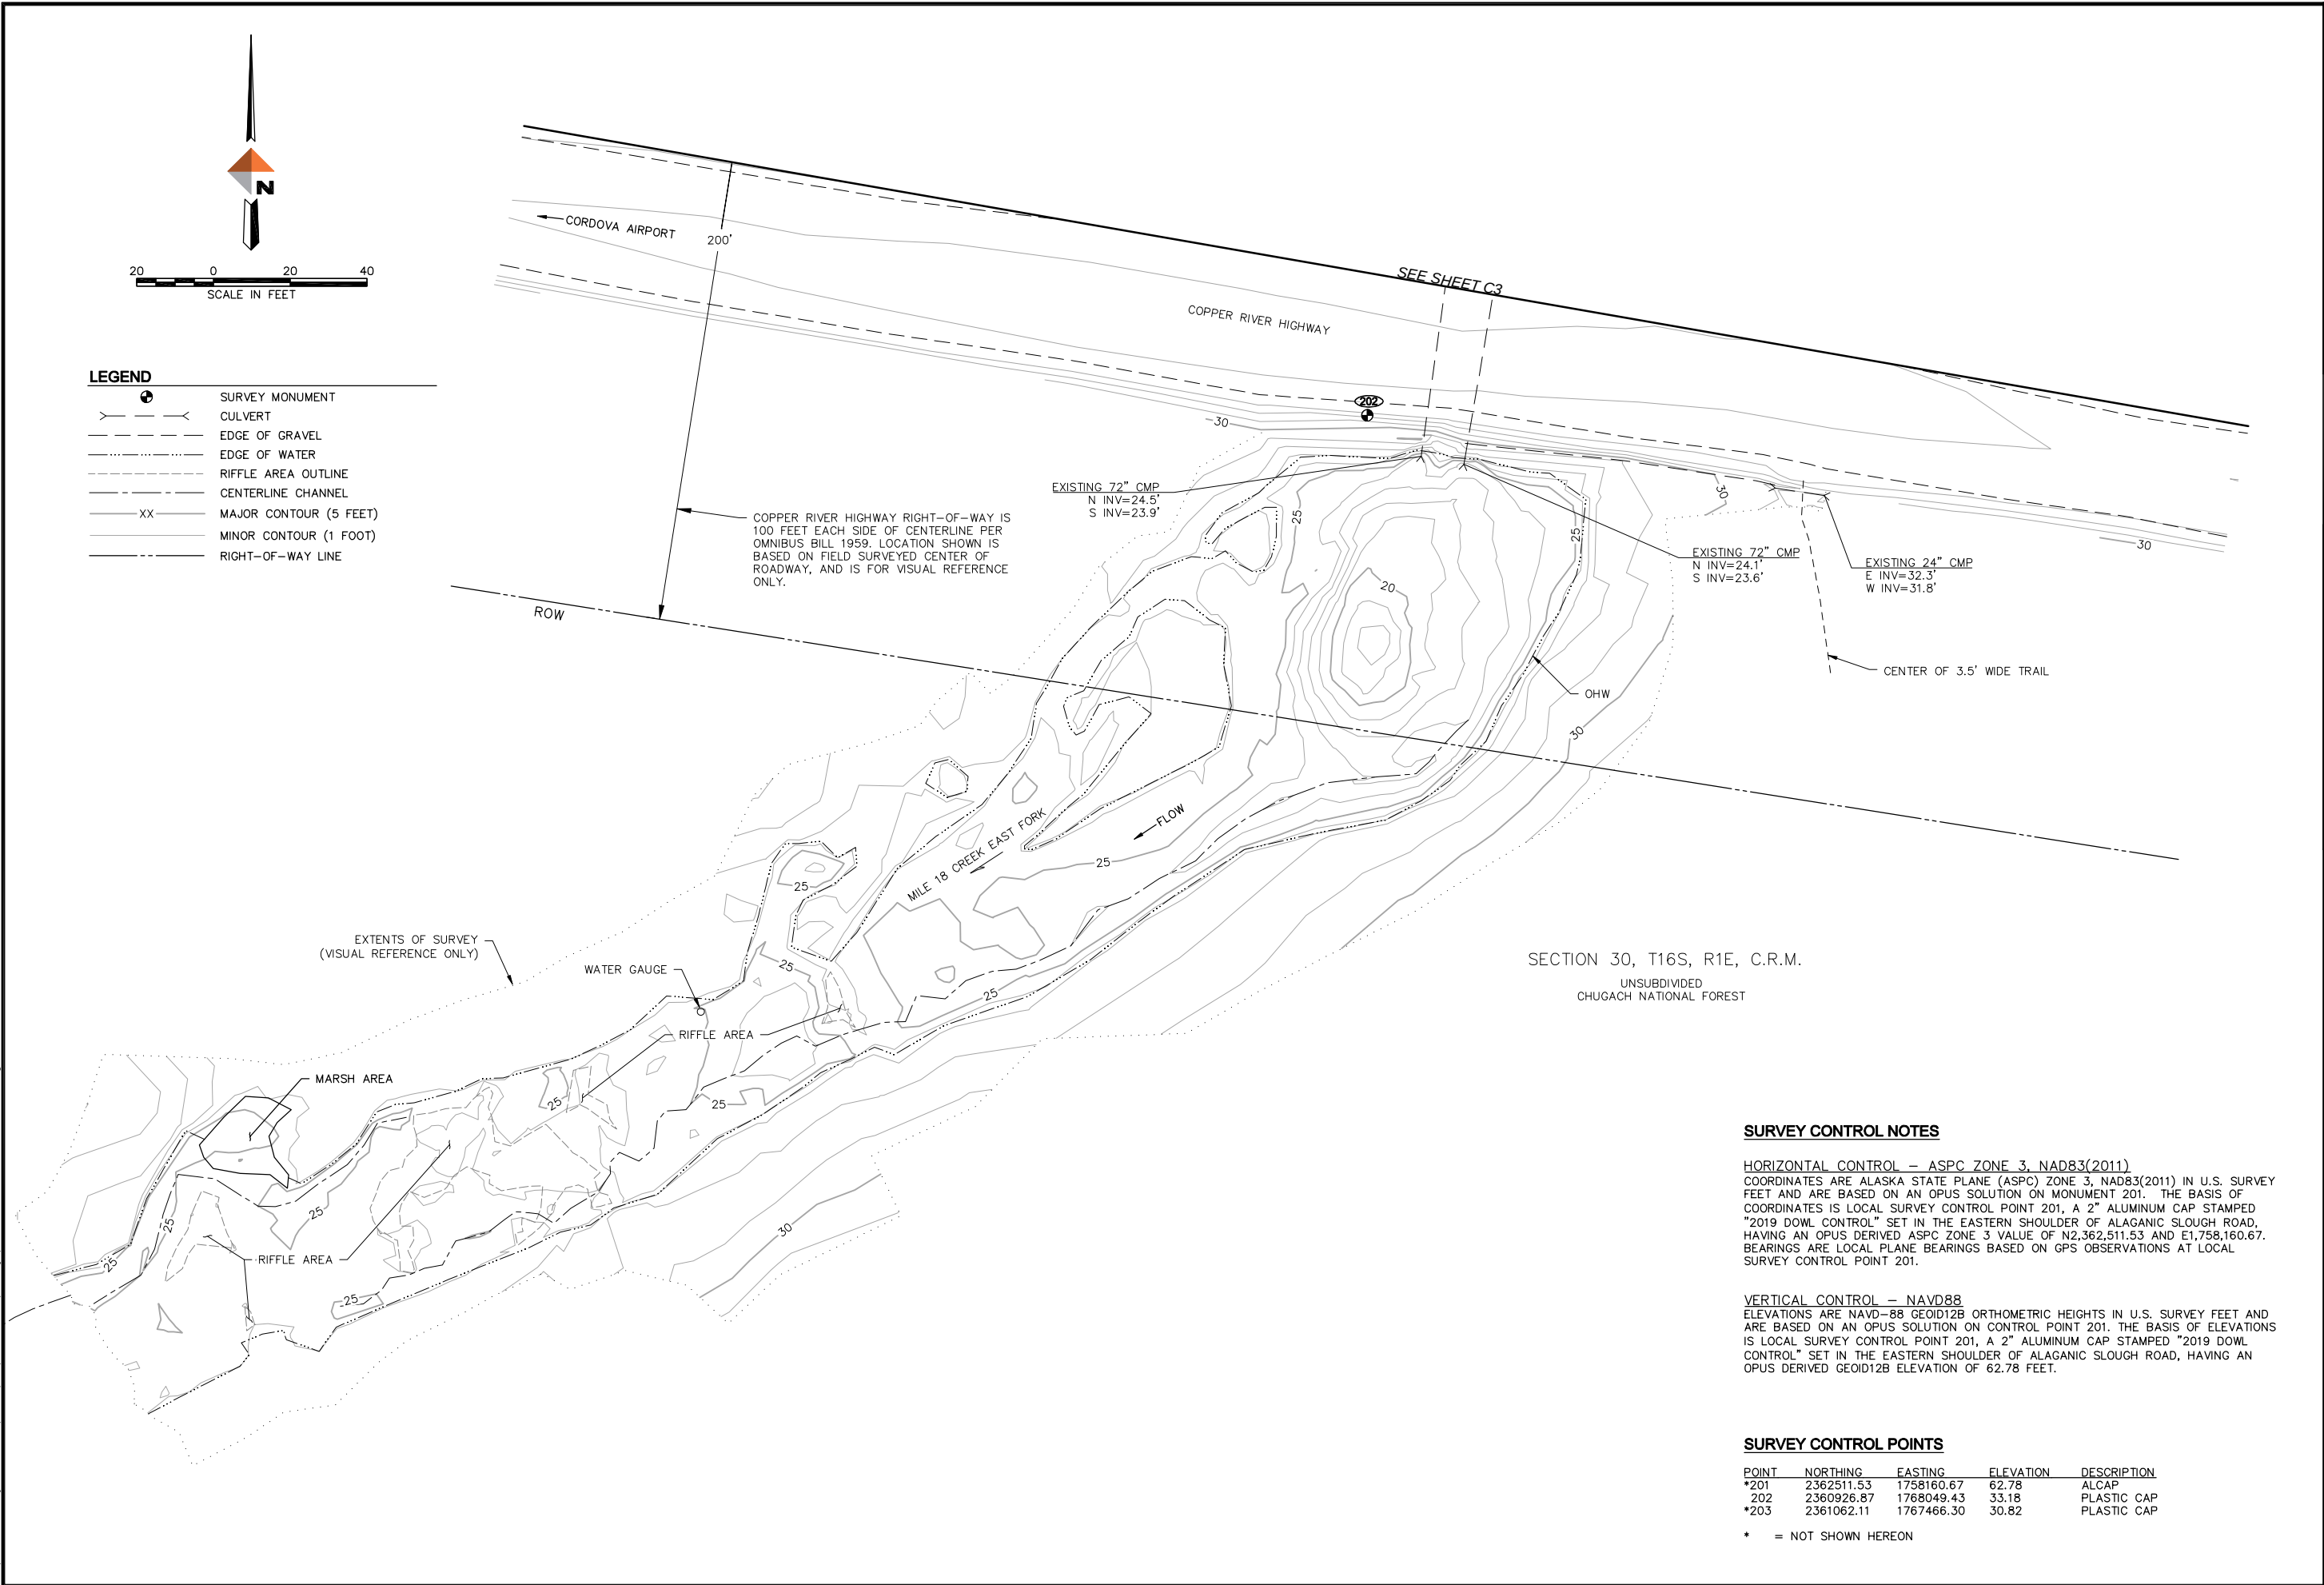

SURVEY CONTROL NOTES

**HORIZONTAL CONTROL – ASPC ZONE 3, NAD83(2011)**  
COORDINATES ARE ALASKA STATE PLANE (ASPC) ZONE 3, NAD83(2011) IN U.S. SURVEY FEET AND ARE BASED ON AN OPUS SOLUTION ON MONUMENT 201. THE BASIS OF COORDINATES IS LOCAL SURVEY CONTROL POINT 201, A 2" ALUMINUM CAP STAMPED "2019 DOWL CONTROL" SET IN THE EASTERN SHOULDER OF ALAGANIC SLOUGH ROAD, HAVING AN OPUS DERIVED ASPC ZONE 3 VALUE OF N2,362,511.53 AND E1,758,160.67. BEARINGS ARE LOCAL PLANE BEARINGS BASED ON GPS OBSERVATIONS AT LOCAL SURVEY CONTROL POINT 201.

**VERTICAL CONTROL – NAVD88**  
ELEVATIONS ARE NAVD-88 GEOID12B ORTHOMETRIC HEIGHTS IN U.S. SURVEY FEET AND ARE BASED ON AN OPUS SOLUTION ON CONTROL POINT 201. THE BASIS OF ELEVATIONS IS LOCAL SURVEY CONTROL POINT 201, A 2" ALUMINUM CAP STAMPED "2019 DOWL CONTROL" SET IN THE EASTERN SHOULDER OF ALAGANIC SLOUGH ROAD, HAVING AN OPUS DERIVED GEOID12B ELEVATION OF 62.78 FEET.

SURVEY CONTROL POINTS

POINT	NORTHING	EASTING	ELEVATION	DESCRIPTION
*201	2362511.53	1758160.67	62.78	ALCAP
*202	2360926.87	1768049.43	33.18	PLASTIC CAP
*203	2361062.11	1767466.30	30.82	PLASTIC CAP

* = NOT SHOWN HEREON

REV

DATE

DESCRIPTION

BY


STATE OF ALASKA  
SOUTH  
A. WILLIAM STOL  
DEC 13 2004  
REGISTERED PROFESSIONAL

DOWL

WWW.DOWL.COM

Cordova Fish Passage Improvements

East Fork 18 Mile Creek – COP 25

SURVEY CONTROL

SECTION 30, T16S, R1E, C.R.M. ALASKA  
CORDOVA RECORDING DISTRICT, ALASKA

PROJECT 1136.63087.01

DATE DECEMBER 2020

© DOWL 2020

SHEET

C4 OF C11
















C:\Civil 3D Projects\2018\1136.63087-01\Hydrology\SC18-CH-DR-63087-COP-25.dwg PLOT DATE 2020-12-04 14:17 SAVED DATE 2020-12-04 14:08 USER: hrbuck

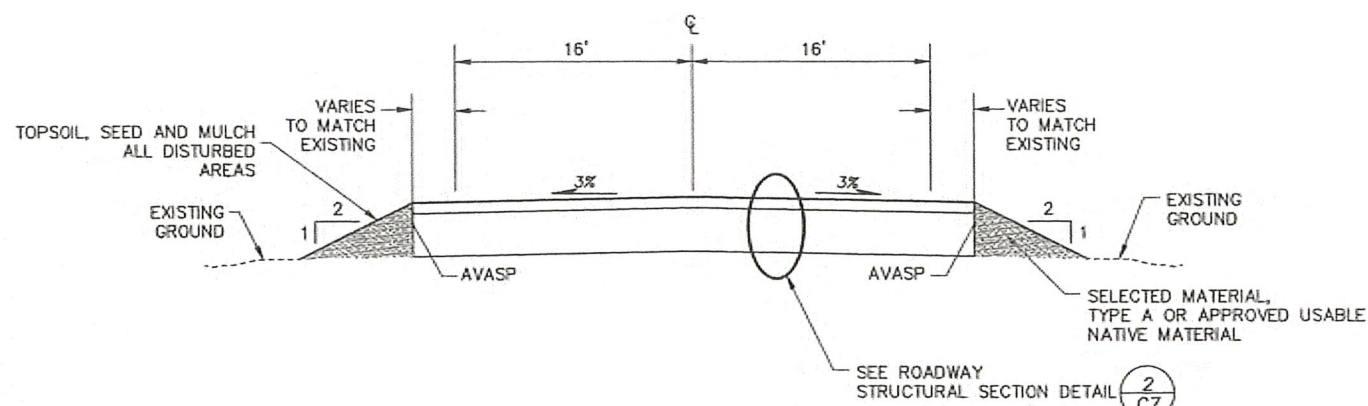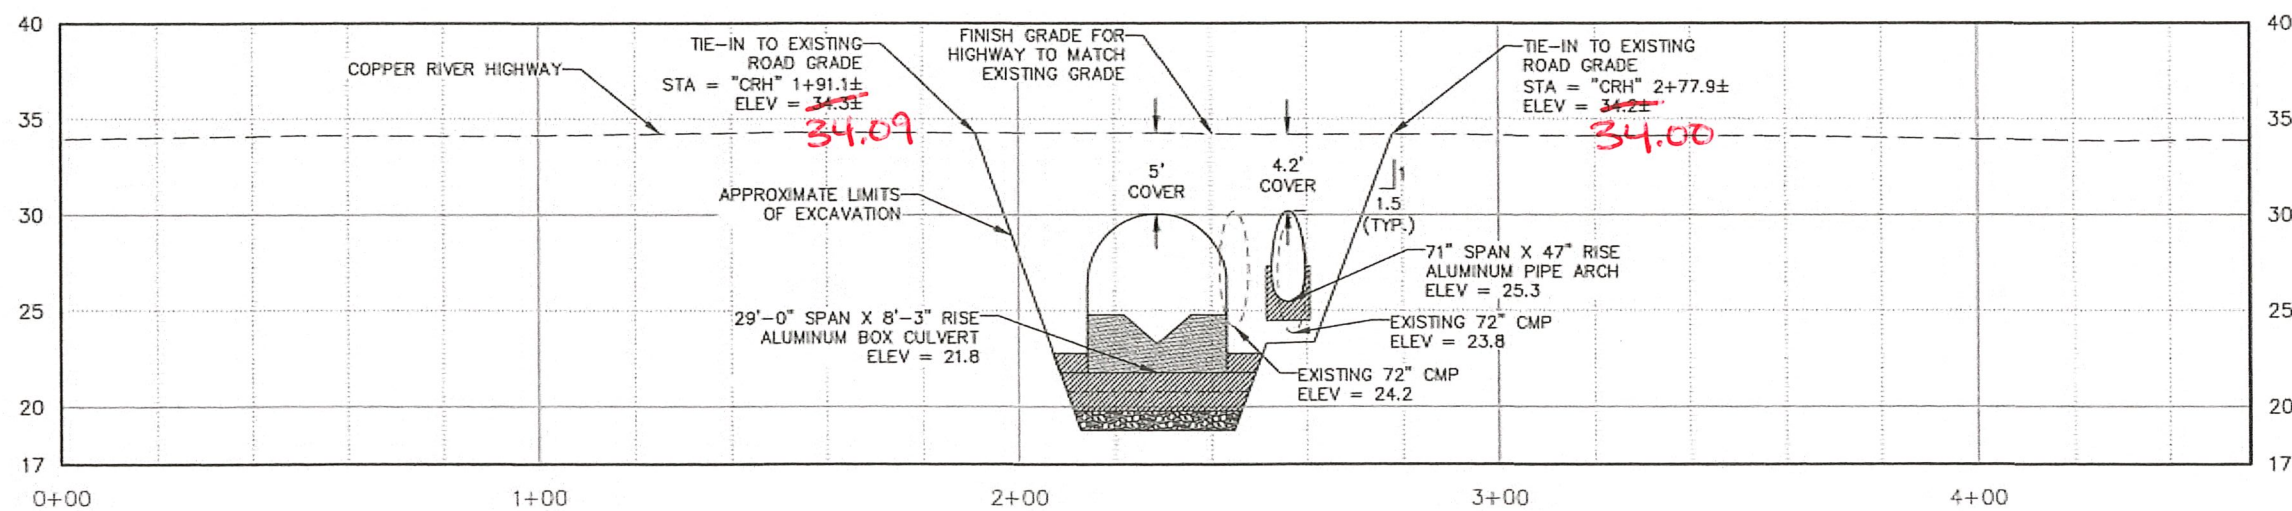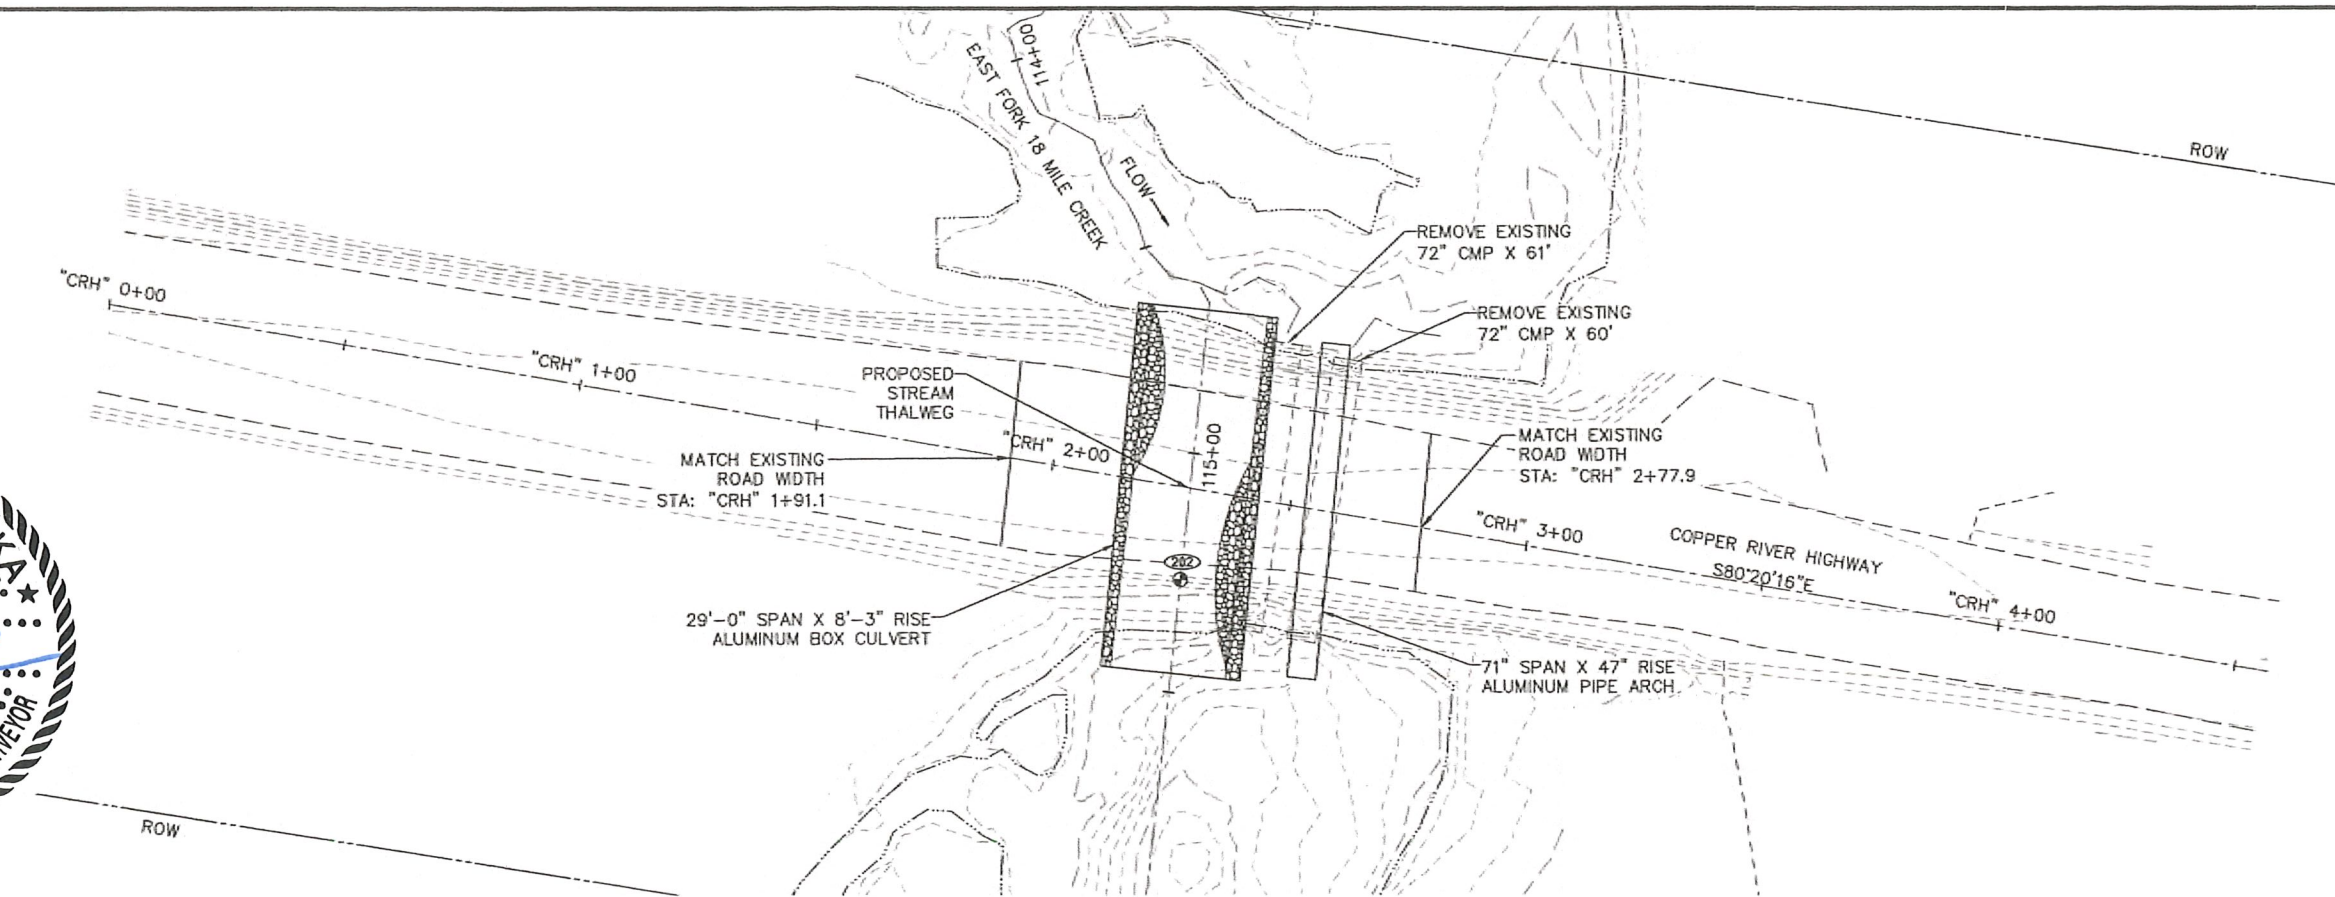
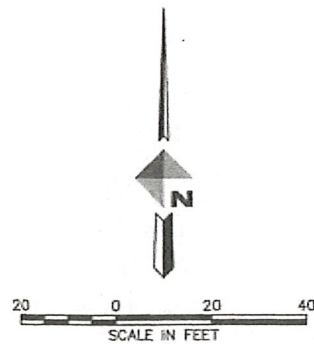


1  
C7  
ROADWAY SECTION  
NTS

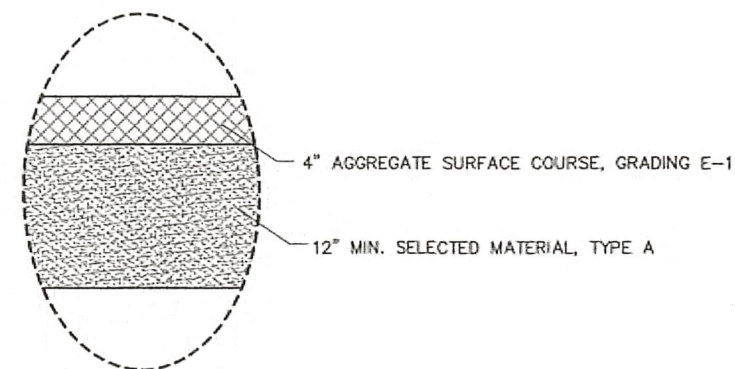

2  
C7  
ROADWAY STRUCTURAL SECTION  
NTS

REV	DATE	DESCRIPTION	BY

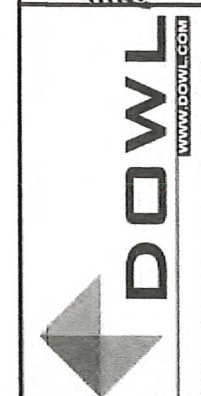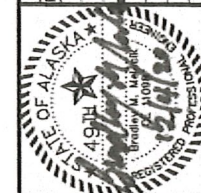

CORDOVA FISH PASSAGE IMPROVEMENTS  
EAST FORK 18 MILE CREEK - COP 25  
ROADWAY PLAN AND PROFILE  
CORDOVA, ALASKA


PROJECT 1136.63087.01  
DATE DECEMBER 2020

© DOWL 2020  
SHEET


C7 OF C11



C:\Civil 3D Projects\2018\2018\36\63087-01\Hydrology\SC18-CH-DR-63087-COP-25.dwg PLOT DATE 2021-1-21 10:39 SAVED DATE 2021-01-21 09:59 USER: hrobuck

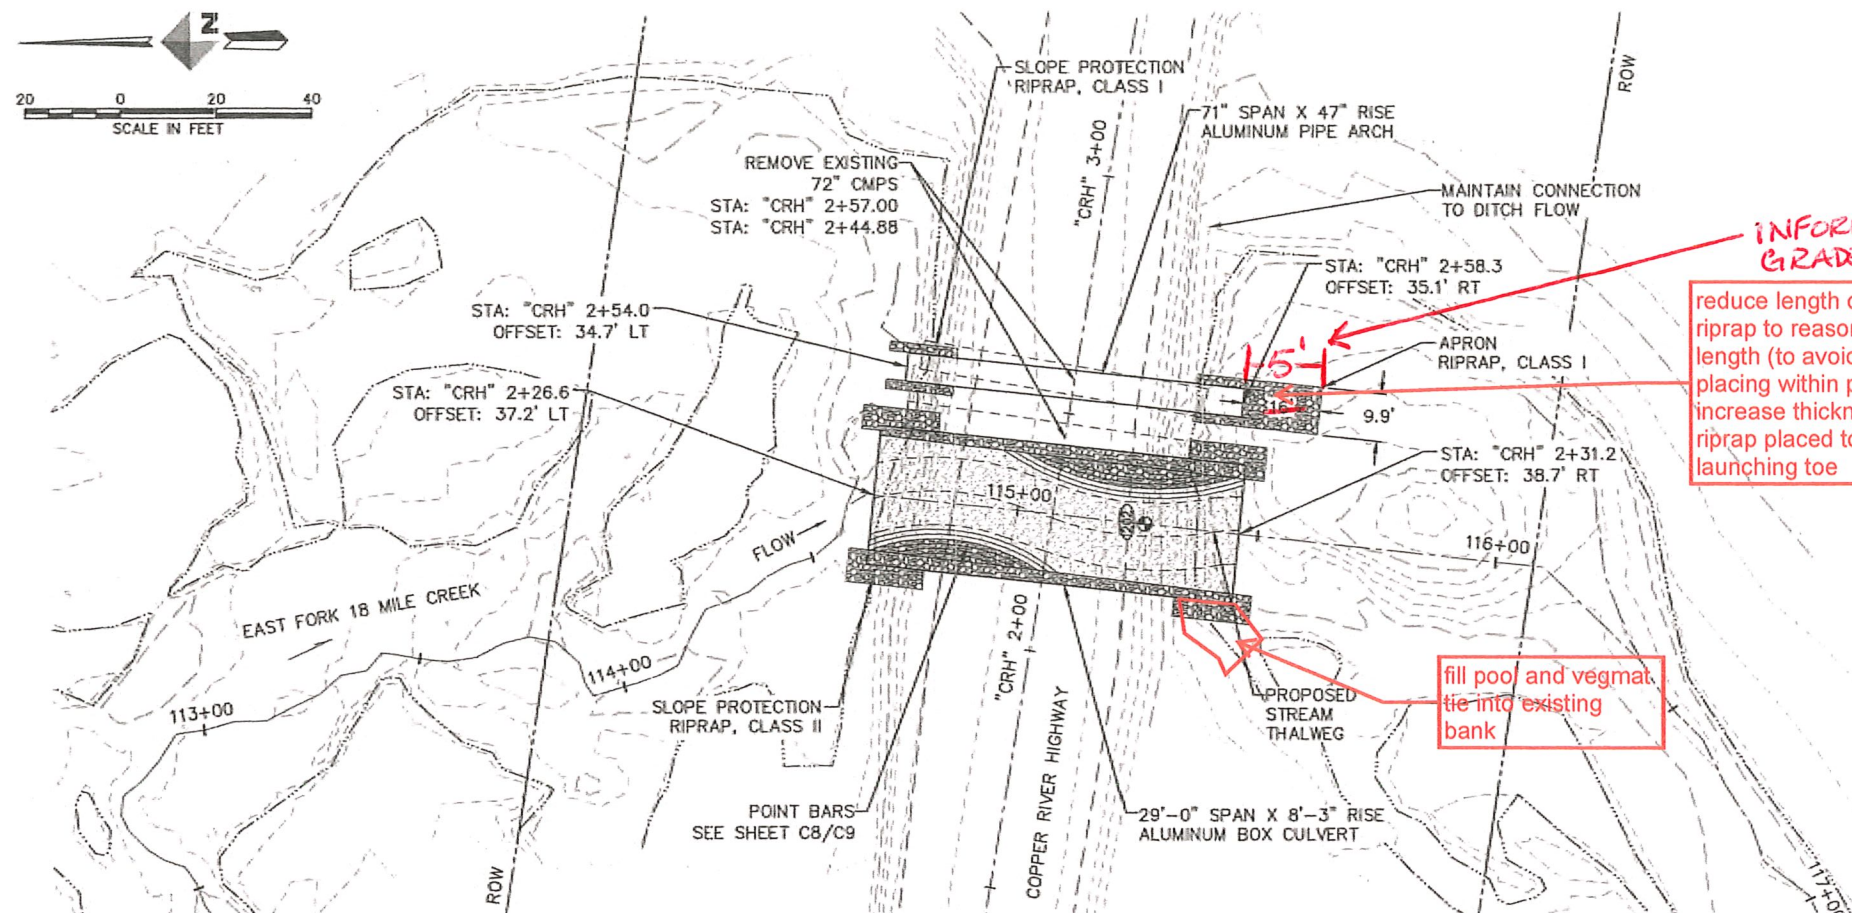

1  
C8  
STREAM SIMULATION DETAIL - PLAN VIEW

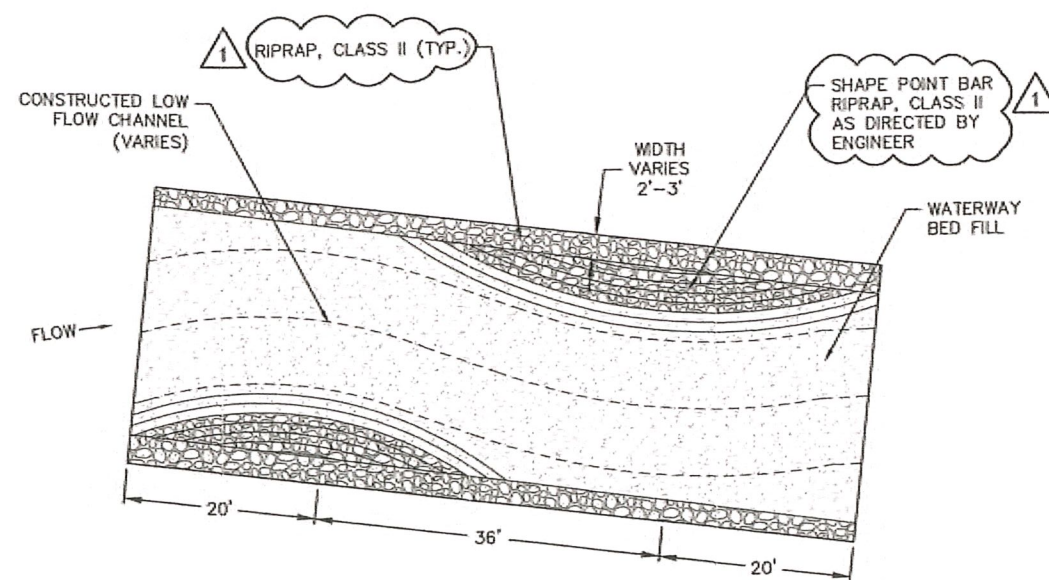

2  
C8  
CULVERT STREAM DETAIL

7/15/2021

REV	DATE	DESCRIPTION	BY
1	1/21/21	ADDENDUM #1	


**DOWL**  
WWW.DOWL.COM

CORDOVA FISH PASSAGE IMPROVEMENTS  
EAST FORK 18 MILE CREEK - COP 25  
STREAM DESIGN DETAILS

PROJECT 1136.63087.01  
DATE DECEMBER 2020


© DOWL 2020  
SHEET  
C8 OF C11



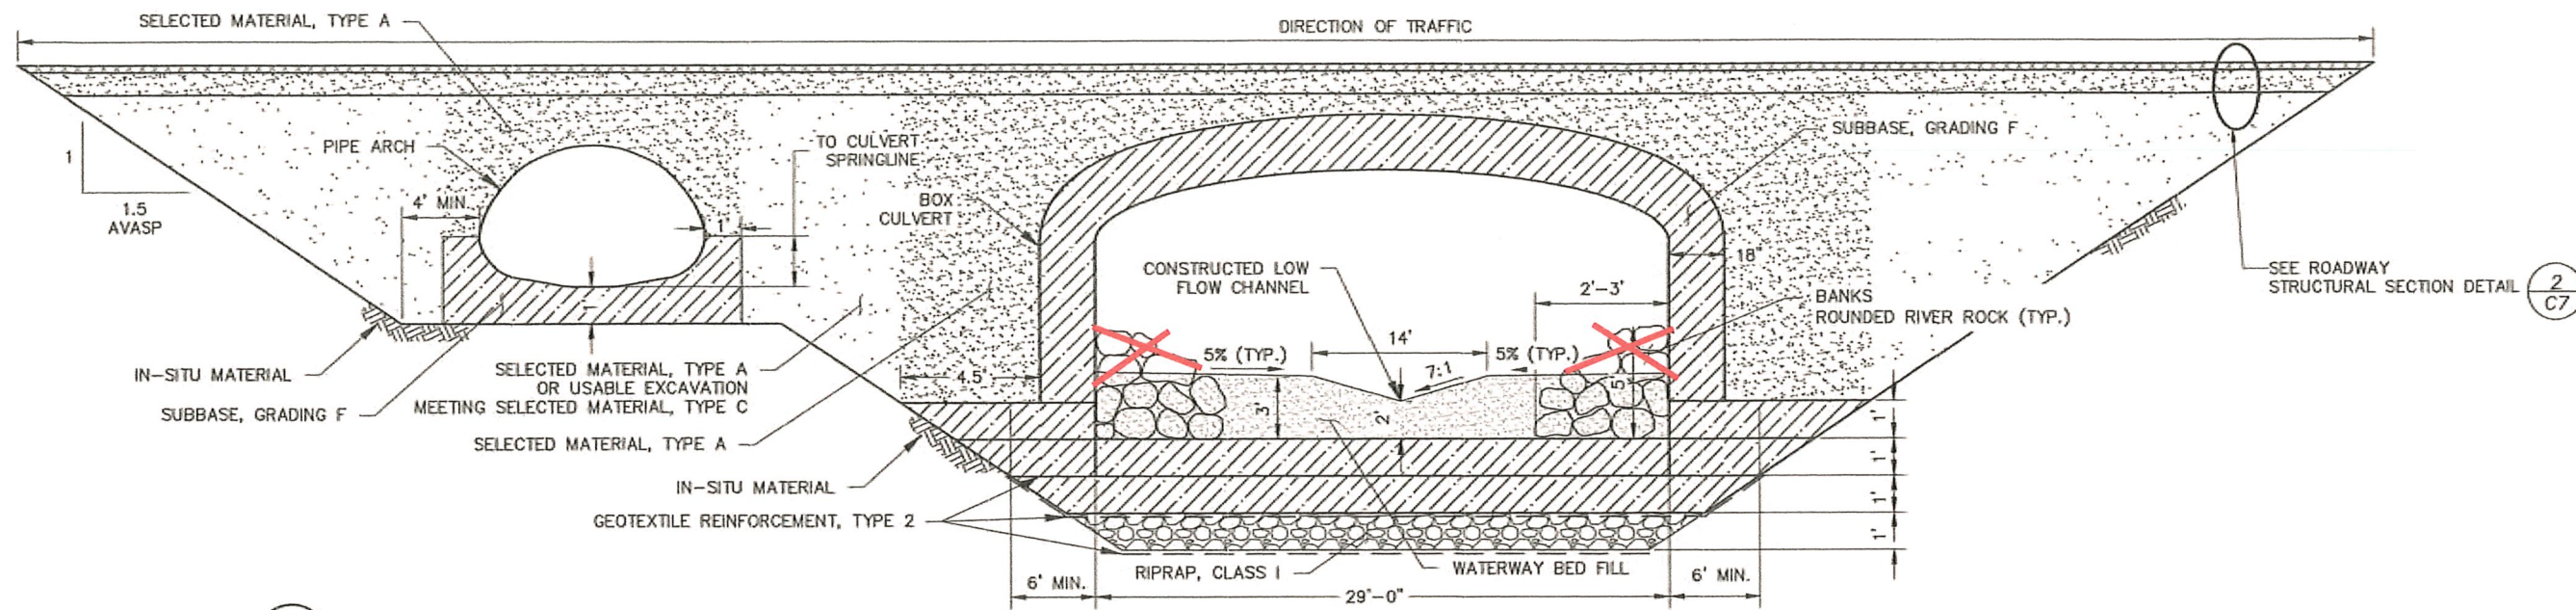

1  
C9

TYPICAL CULVERT SECTION  
NTS

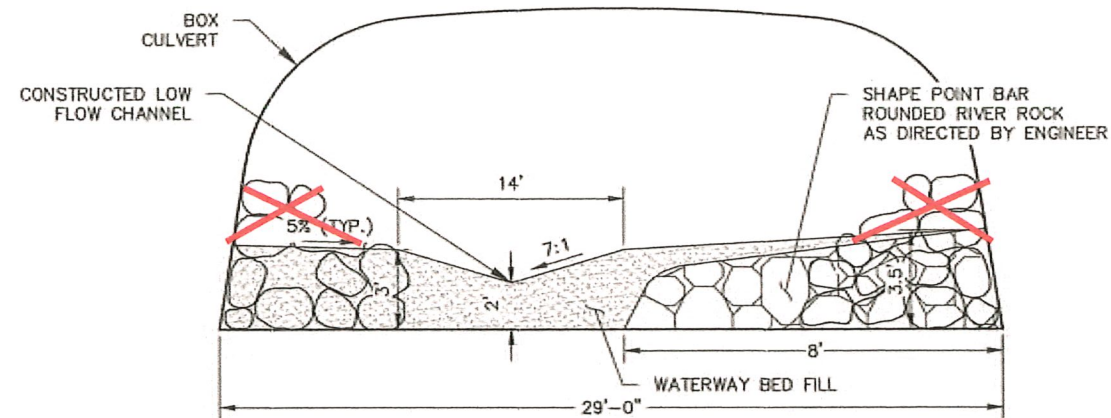


2  
C9

CULVERT SECTION AT ROCK CLUSTER


NTS

- NOTES:

1. GEOTEXTILE REINFORCEMENT, TYPE 2 SHALL BE PLACED BETWEEN IN-SITU MATERIAL AND RIPRAP, CLASS I, PLACED BETWEEN RIPRAP, CLASS I AND SUBBASE, GRADING F, AND PLACED BETWEEN EACH ONE-FOOT LAYER OF SUBBASE, GRADING F.
2. FILL VOIDS IN RIPRAP. MIX RIPRAP WITH FINES PRIOR TO PLACEMENT AND WASH FINES IN AFTER PLACEMENT.

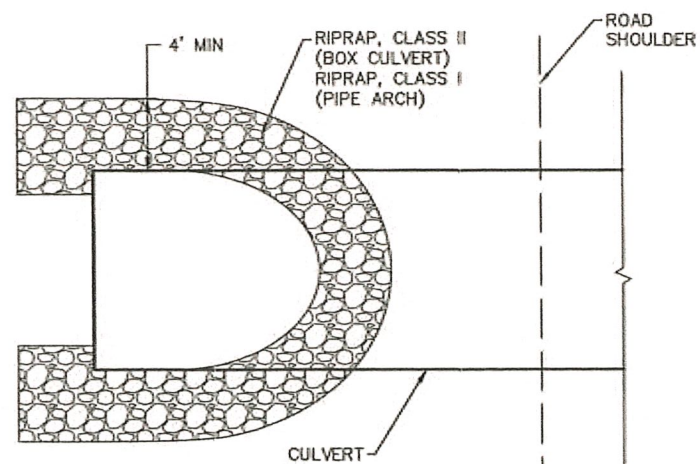

PLAN

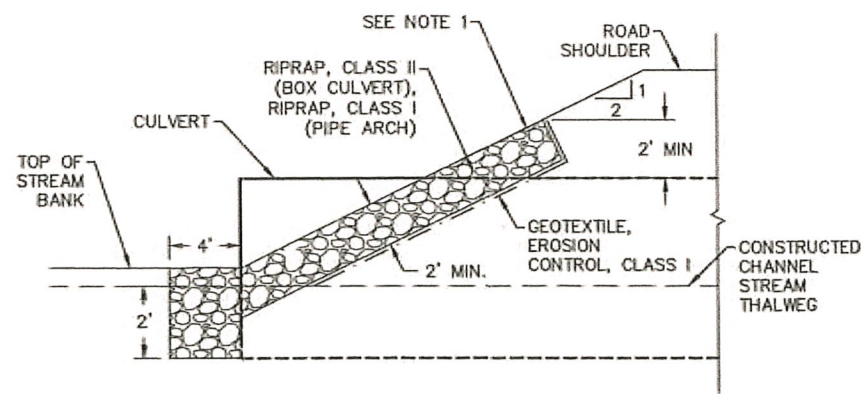

PROFILE

3  
C9

RIPRAP SLOPE PROTECTION SECTION  
NTS

- NOTES:

1. FILL VOIDS IN RIPRAP WITH SELECTED MATERIAL, TYPE A OR USABLE EXCAVATION MEETING SELECTED MATERIAL, TYPE C AND PLACE SALVAGED ORGANIC TOPSOIL AND SEED.




REFER TO SPECIFICATIONS FOR ROAD CLOSURE AND TRAFFIC CONTROL INFORMATION

DUE TO PERMISSIVITY OF GRAVELS IN THE 18 MILE AREA, A COFFERDAM MADE OF SHEET PILE MAY BE NEEDED TO REDUCE GROUNDWATER FLOW INTO EXCAVATED AREA. TEMPORARY DIKES OR BERMS MAY BE USED TO ISOLATE THE WORK AREA FROM WATERS OF THE SURROUNDING AREA. THIS WORK MAY REQUIRE A DIVERSION OF STREAM WATER. THE DESIGNERS RECOGNIZE THAT DIFFERENT CONTRACTORS WILL HAVE VARIOUS APPROACHES FOR CONTROLLING WATER AND CONSTRUCTION SEQUENCING. THIS DIVERSION PLAN HAS BEEN DEVELOPED TO CHECK FOR CONSTRUCTABILITY AND AS A STARTING POINT FOR A CONTRACTOR-GENERATED PLAN. CONTRACTOR MUST SUBMIT DIVERSION PLANS TO ENGINEER FOR APPROVAL PRIOR TO IMPLEMENTATION.

1. PLACE BARRICADES, SIGNS, AND TEMPORARY ROAD DETOUR IN COMPLIANCE WITH SPECIFICATIONS, ADOT&PF, AND MUTCD. COORDINATE WITH OTHER CONTRACTORS WHO MAY BE PRESENT.
2. CONSTRUCT VISQUEEN LINED DIVERSION CHANNEL.
3. USE EXISTING EAST 72" CMP IN DIVERSION CHANNEL TO PROVIDE VEHICULAR ACCESS. CONSTRUCT DIVERSION CHANNEL BANKS TO BE MINIMUM 1' HIGHER THAN THE TOP OF THE DIVERSION PIPE, IF USED.
4. USE BULK BAGS (SUPERSACKS) TO DIVERT STREAM FLOW THROUGH DIVERSION CHANNEL. LOCATION OF DIVERSION CHANNEL IS APPROXIMATE AND SUBJECT TO SITE CONDITIONS.
5. EXCAVATE ROADWAY TO REMOVE EXISTING WEST 72" CULVERT.
6. CONSTRUCT THE NEW ALUMINUM BOX CULVERT.
7. INFILL CULVERT AND RECONSTRUCT CREEK CHANNEL AS SHOWN IN PLANS.
8. DIVERT CREEK FLOW THROUGH THE NEW ALUMINUM BOX CULVERT.
9. REMOVE EXISTING EAST 72" CULVERT.
10. CONSTRUCT THE NEW ALUMINUM PIPE ARCH OVERFLOW CULVERT. FILL DIVERSION CHANNEL.
11. RECONSTRUCT CREEK CHANNEL AND BANKS AS SHOWN IN PLANS.
12. RECONSTRUCT COPPER RIVER HIGHWAY OVER THE NEWLY INSTALLED CULVERTS.
13. STABILIZE AND REVEGETATE ALL REMAINING DISTURBED AREAS.
14. RETURN VEHICULAR TRAFFIC TO COPPER RIVER HIGHWAY.

1. DEWATER TRENCH AND WORK AREA WITH PUMP HOSE IF REQUIRED.
2. ALL DISCHARGE POINTS REQUIRE PERMANENT OR TEMPORARY VELOCITY CONTROLS.
3. PROVIDE FOR SEDIMENT REMOVAL FOR ALL DEWATERING ACTIVITY PRIOR TO DISCHARGE FROM THE PROJECT INTO ANY WATER OF THE U.S.
4. PROVIDE SPARE (EXTRA) PUMPS FOR BOTH THE STREAM BYPASS PUMP AND DETWATERING PUMP.
5. EXISTING RIPARIAN VEGETATION SHOULD BE PROTECTED TO MINIMIZE DISTURBANCE.
6. SILT FENCING TO BE USED TO PREVENT DISTURBED SEDIMENT FROM ENTERING THE WATERBODY. ADJUST LOCATION AS NECESSARY AND AS DIRECTED BY THE ENGINEER DURING CONSTRUCTION.
7. EROSION AND SEDIMENT CONTROL DEVICES SHALL BE INSPECTED AND MAINTAINED ON A DAILY BASIS. MAINTENANCE SHALL INCLUDE REMOVAL AND DISPOSAL OF ACCUMULATED SEDIMENT, CLEANING AND REPAIR OF DAMAGED SEDIMENT CONTROL DEVICES.
8. ALL DISTURBED GROUND CAPABLE OF SUPPORTING VEGETATION SHALL BE REVEGETATED FOR FINAL STABILIZATION. ALL AREAS NOT REVEGETATED SHALL BE 100% COVERED BY ROCK OR OTHER PERMANENT NON-ERODIBLE MATERIAL. FINAL STABILIZATION SHALL BE AS APPROVED BY THE ENGINEER.

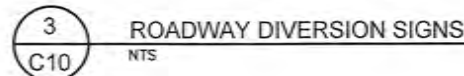[illegible]

**DOW**  
WWW.DOW.COM

**CORDOVA FISH PASSAGE IMPROVEMENTS  
EAST FORK 18 MILE CREEK – COP 25  
ESCP, STREAM DIVERSION & ROADWAY  
DIVERSION PLAN**  
CORDOVA, ALASKA

PROJECT 1136.63087.01
DATE DECEMBER 2020

© DOWL 2020



SHEET

C10 OF C11

_____



C:\Civil 3D Projects 2018\2018\36\63087-01\Hydrology\SC18-CH-DR-63087-COP-25.dwg PLOT DATE 2021-1-21 10:52 SAVED DATE 2021-01-21 10:41 USER: hrbuck

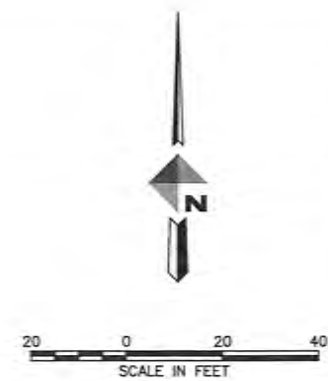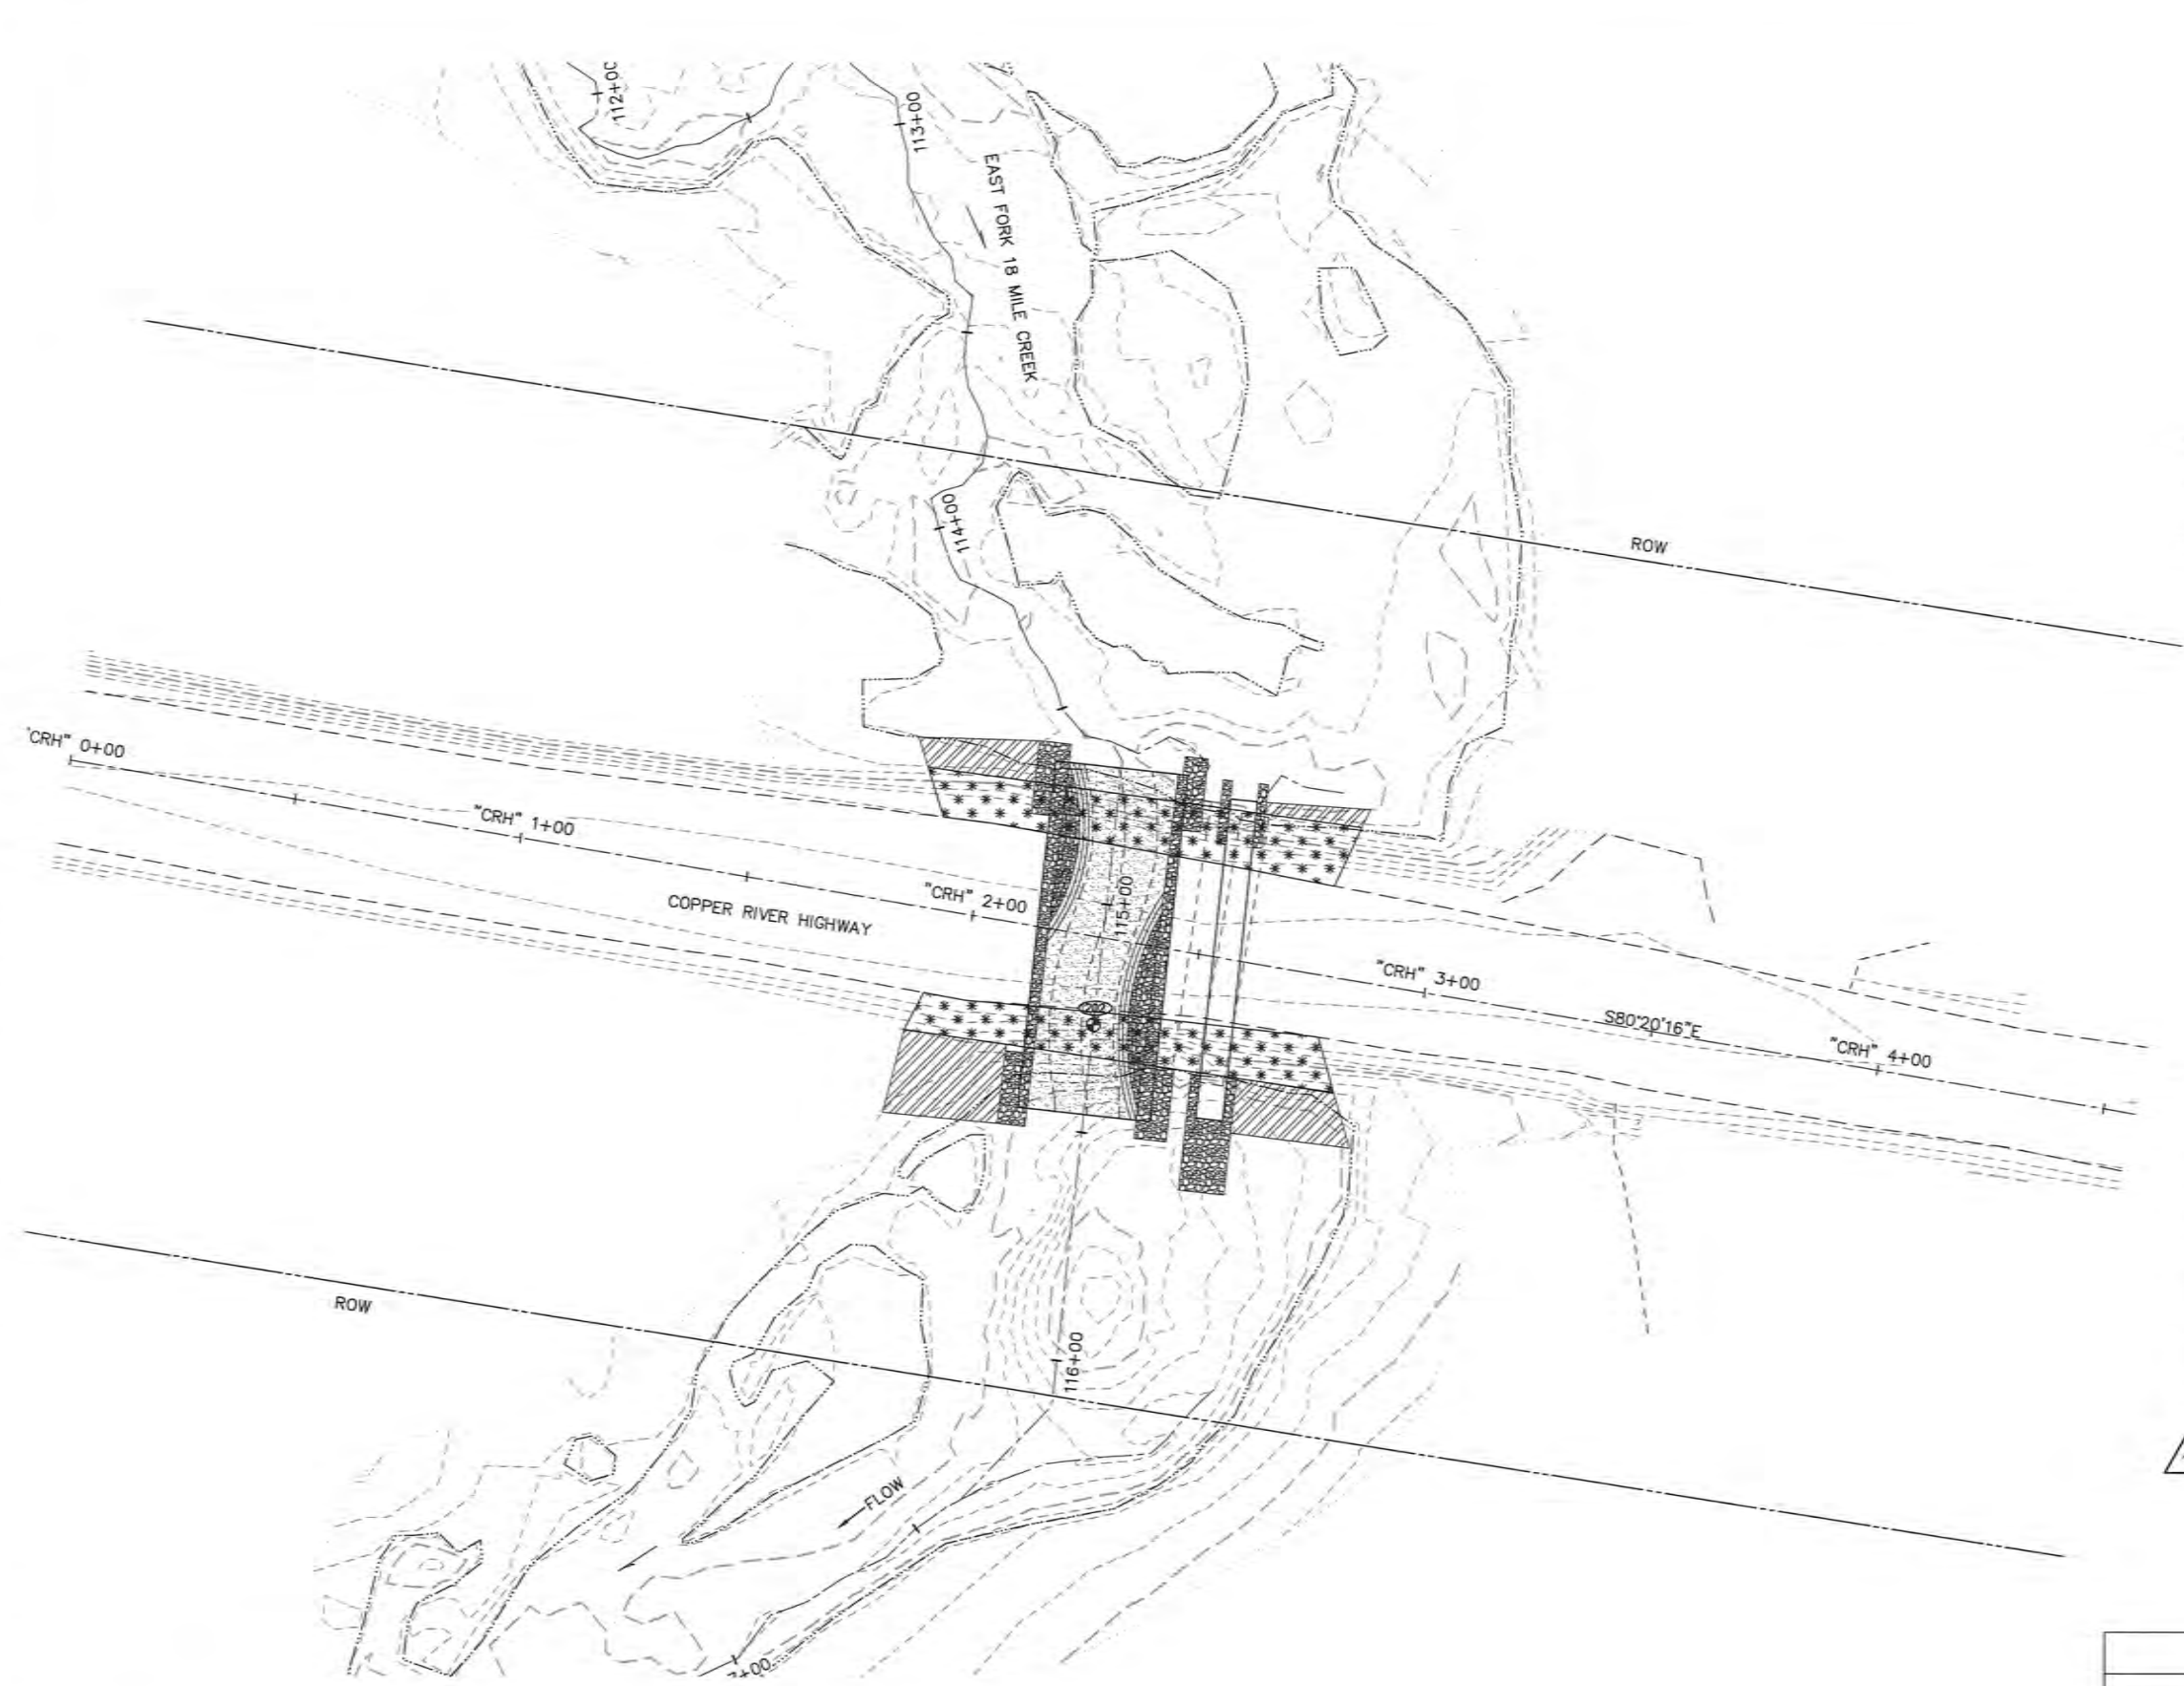

- NOTES:
1. VEGETATIVE MAT SHALL BE PLACED ON ALL DISTURBED AREAS OUTSIDE OF THE EMBANKMENT SLOPES.
  2. SALVAGED VEGETATIVE MAT MUST HAVE A MINIMUM THICKNESS OF 12 INCHES AND BE SOURCED FROM THE DISTURBED AREA OR LOCAL AREA AS DIRECTED BY THE ENGINEER.

SITE REVEGETATION

	SEED, FERTILIZER, AND MULCH
	VEGETATIVE MAT
	CONSTRUCTED STREAM CHANNEL WATERWAY BED FILL
	RIPRAP
	ROUNDED RIVER ROCK

SEED	
NAME	PROPORTION BY WEIGHT
NORTAN TUFTED HAIR GRASS, DESCHAMPISA CAESPITOSIA	20%
ARCTARED' RED FESCUE, FESTUCA RUBRA	60%
CALAMANGROTIS CANADENSIS	20%

1 REVEGETATION PLAN  
C11

REV	DATE	DESCRIPTION	BY
1	1/21/21	ADDENDUM #1	

CORDOVA FISH PASSAGE IMPROVEMENTS  
EAST FORK 18 MILE CREEK - COP 25  
REVEGETATION PLAN  
CORDOVA, ALASKA

PROJECT 1136.63087.01  
DATE DECEMBER 2020

© DOWL 2020  
SHEET

C11 OF C11